













This document and the ideas and design incorporated herein, as an instrument of professional service, is the property of EDG and is to be used in whole or part, for any other project without the written authorization of EDG. This document is not to be reproduced or modified in any way, nor shall any reproduction of this document be modified, with out prior written consent of EDG. This drawing represents visual concepts and construction suggestions only; it does not replace the knowledge and advice of a licensed structural engineer. The designer does not warrant, in any way, the accuracy of this information and shall not be responsible for discrepancies between this document and the existing conditions. The designer will not assume responsibility for improper engineering, construction, handling or use of the lighting equipment.

INSTRUMENT KEY

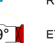-  PRG Best Boy HP
-  PRG Best Boy HP Ground Control
-  Clay Paky Mythos
-  Philips Vari-Lite VL2500 Spot
-  PRG ICON Beam
-  Colorblast TRX
-  TMB Solaris Flare
-  TMB Solaris Flare Jr
-  TMB Solaris Flare LR
-  GLP JDC-1 Strobe
-  Martin Rush PAR 2 RGBW
-  ETC Source 4 19 deg

VENUE
WARNER BROS STAGE 16
BURBANK, CA

ELLEN'S GAME OF GAMES SEASON 3

LOAD-IN 05/21/19 SHOWDAY 06/19/19 SHOW # #1905

DESIGNER TRAVIS HAGENBUCH
LEAD L.D. BEN GREEN
GAFFER PAUL BELL JR.
PROG. 1: RYAN TANKER
PROG. 2: PATRICK BRAZIL
LEAD TECH ROBB MINNOTTE

01. FIRST ISSUE
02. CUTS FOR BUDGET
03. AS BUILT

0" 1" 2"

PRINT ARCH D SHEET


DRAWN BY: BG / TH SCALE: 1/8" = 1'-0"

LX-01: OVERVIEW
LX-02: FLOOR

SHEET #
LX-01

PUBLISH DATE
06/27/2019

OVERVIEW

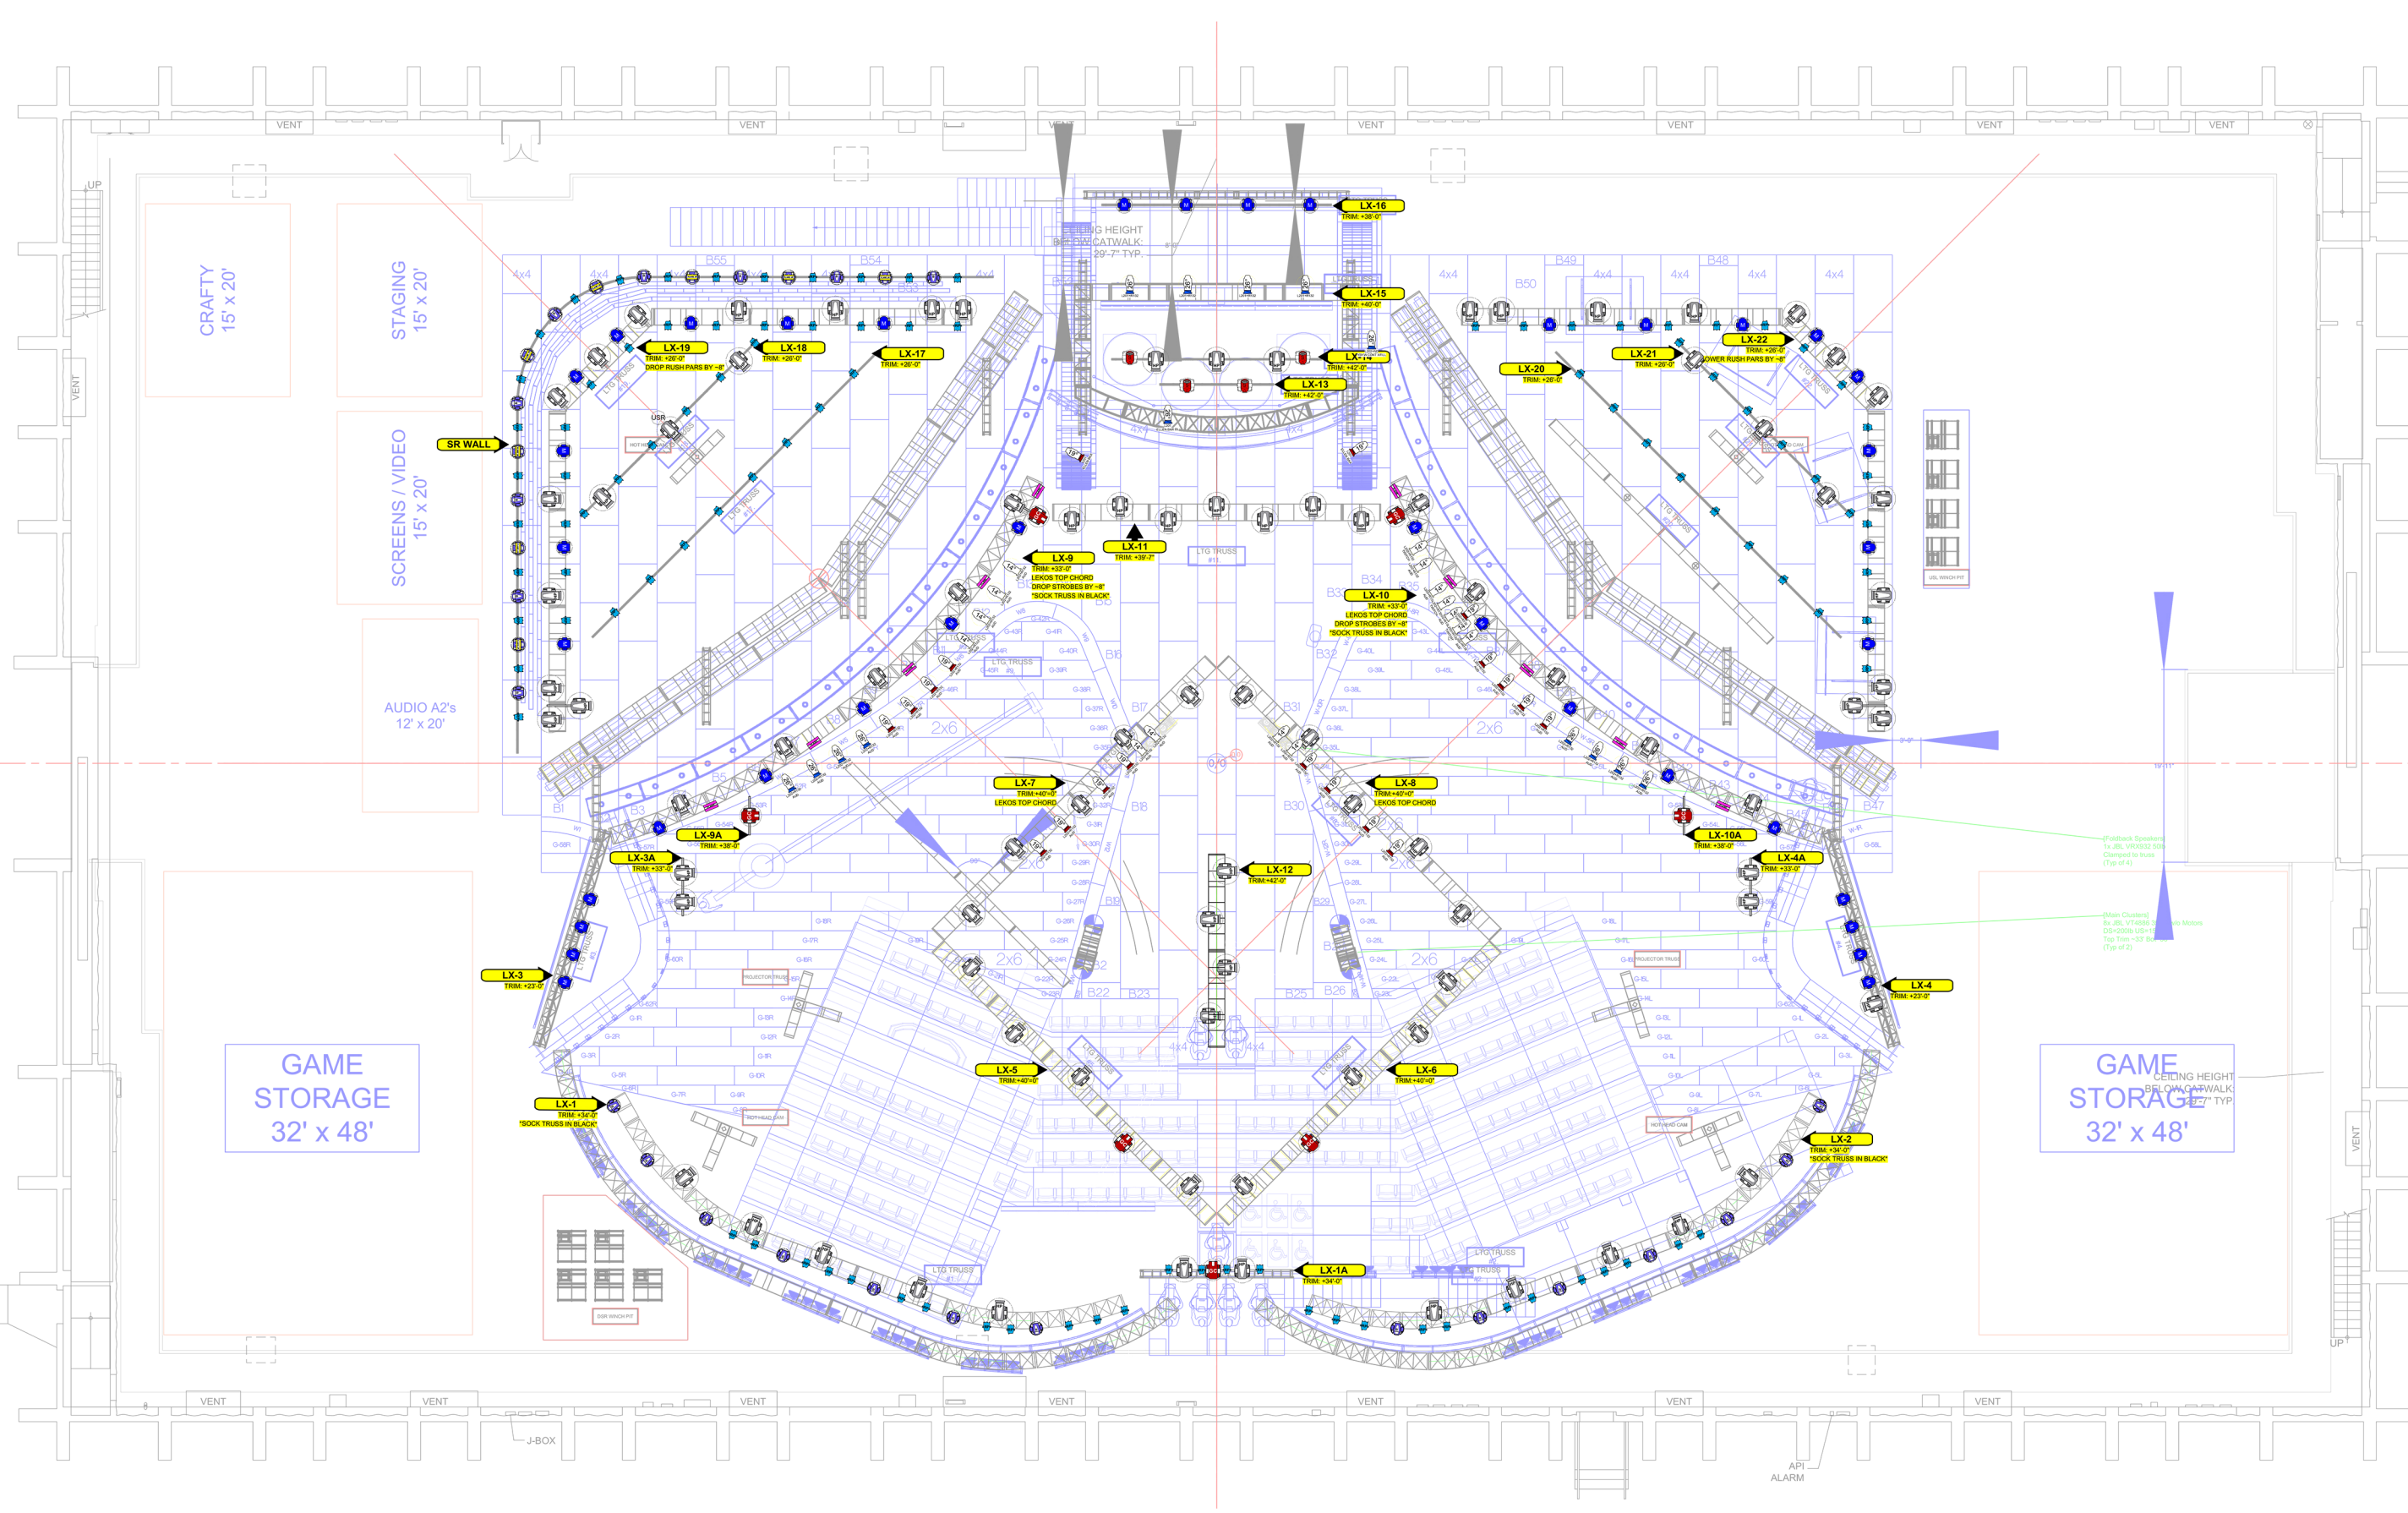

06/27/2019

OVERVIEW