



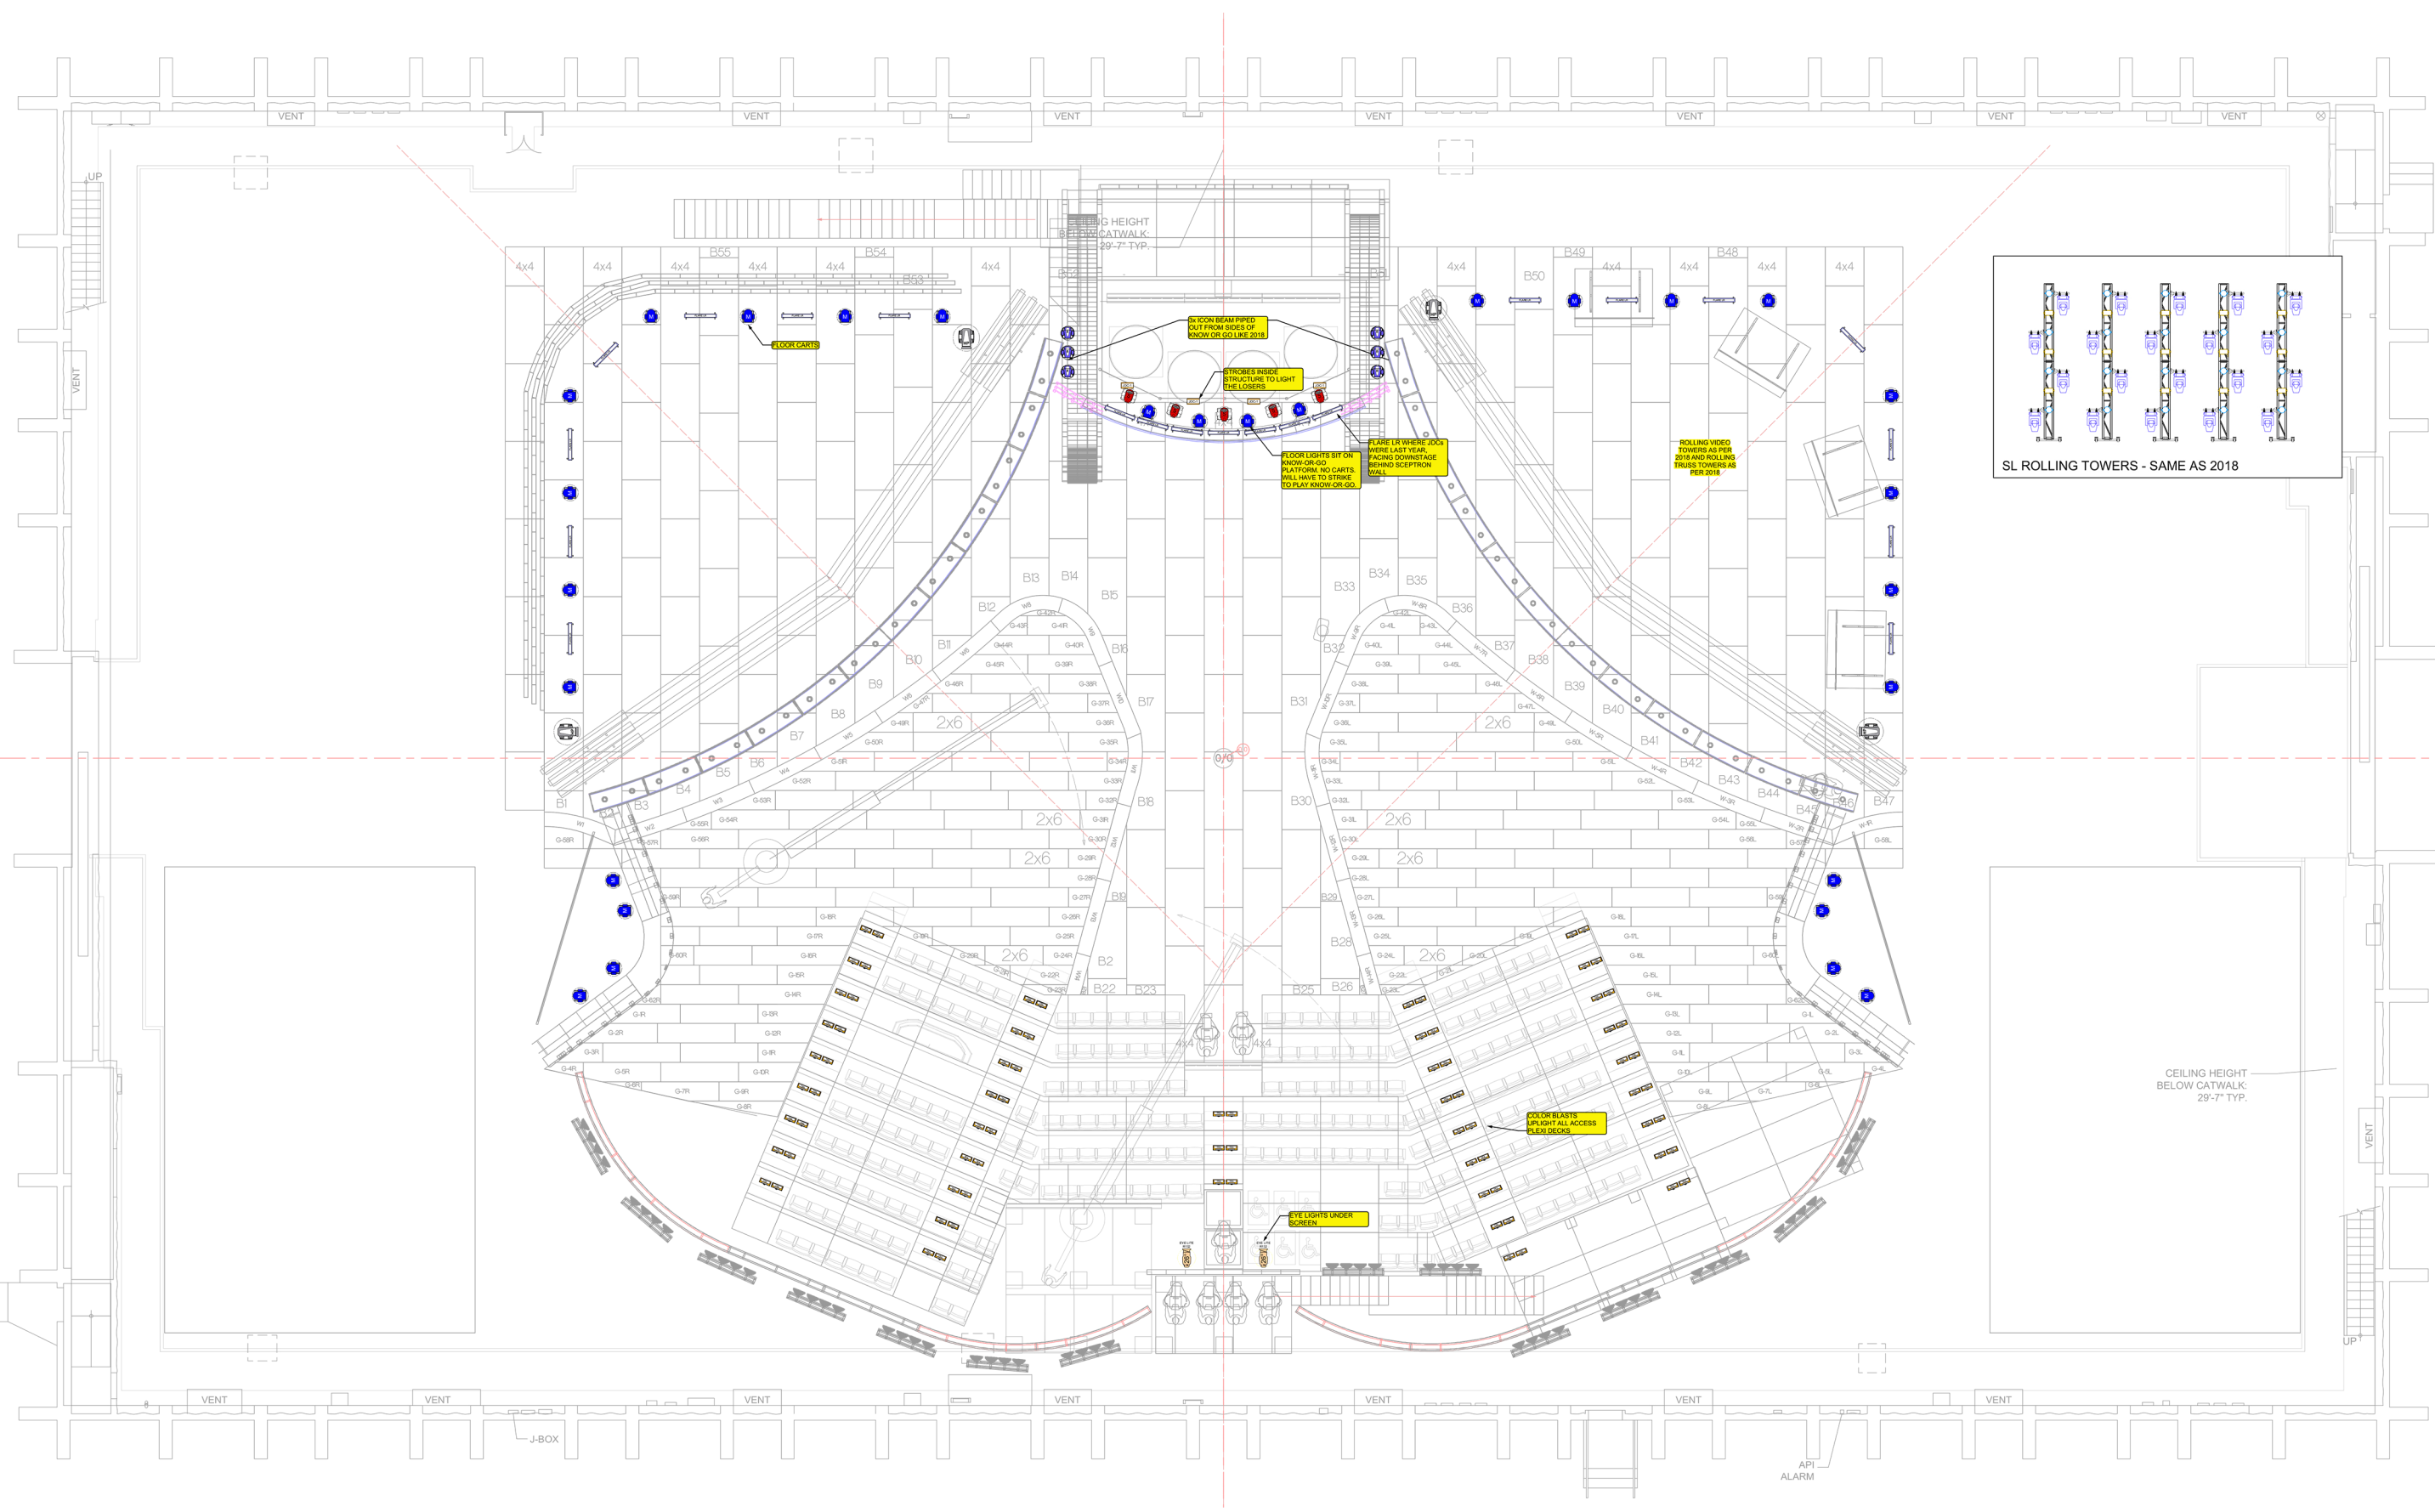

This document and the ideas and design incorporated herein, as an instrument of professional service, is the property of EDG and is to be used, in whole or part, for any other project without the written authorization of EDG. This document is not to be reproduced or modified in any way, nor shall any reproduction of this document be modified, with out prior written consent of EDG. This drawing represents visual concepts and construction suggestions only; it does not replace the knowledge and advice of a licensed structural engineer. The designer does not warrant, in any way, the accuracy of this information and shall not be responsible for discrepancies between this document and the existing conditions. The designer will not assume responsibility for improper engineering, construction, handling or use of this lighting equipment.

**INSTRUMENT KEY**

- PRG Best Boy HP
- PRG Best Boy HP Ground Control
- Clay Paky Mythos
- Philips Vari-Lite VL2500 Spot
- PRG ICON Beam
- Colorblast TRX
- TMB Solaris Flare
- TMB Solaris Flare Jr
- TMB Solaris Flare LR
- GLP JDC-1 Strobe
- Martin Rush PAR 2 RGBW
- ETC Source 4 19 deg

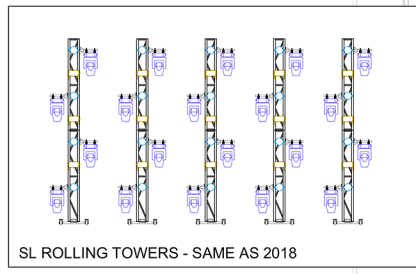

CEILING HEIGHT  
CATWALK:  
29'-7" TYP.

CEILING HEIGHT  
BELOW CATWALK:  
29'-7" TYP.

VENUE  
WARNER BROS STAGE 16  
BURBANK, CA

**ELLEN'S  
GAME OF GAMES  
SEASON 3**

LOAD-IN SHOWDAY SHOW #  
05/21/19 06/19/19 #1905

DESIGNER	TRAVIS HAGENBUCH
LEAD L.D.	BEN GREEN
GAFFER	PAUL BELL JR.
PROG. 1:	RYAN TANKER
PROG. 2:	PATRICK BRAZIL
LEAD TECH	ROBB MINNOTTE

VERSION  
01. FIRST ISSUE  
02. CUTS FOR BUDGET  
03. AS BUILT

PRINT ARCH D SHEET  
DRAWN BY: BG / TH SCALE: 1/8" = 1'-0"

CONTENTS  
LX-01: OVERVIEW  
LX-02: FLOOR

SHEET #  
**LX-02**

PUBLISH DATE  
06/27/2019

FLOOR